



194

BASE $E\frac{1}{2} \times 6\frac{1}{2} \times 0'-9"$
HSS COLUMN

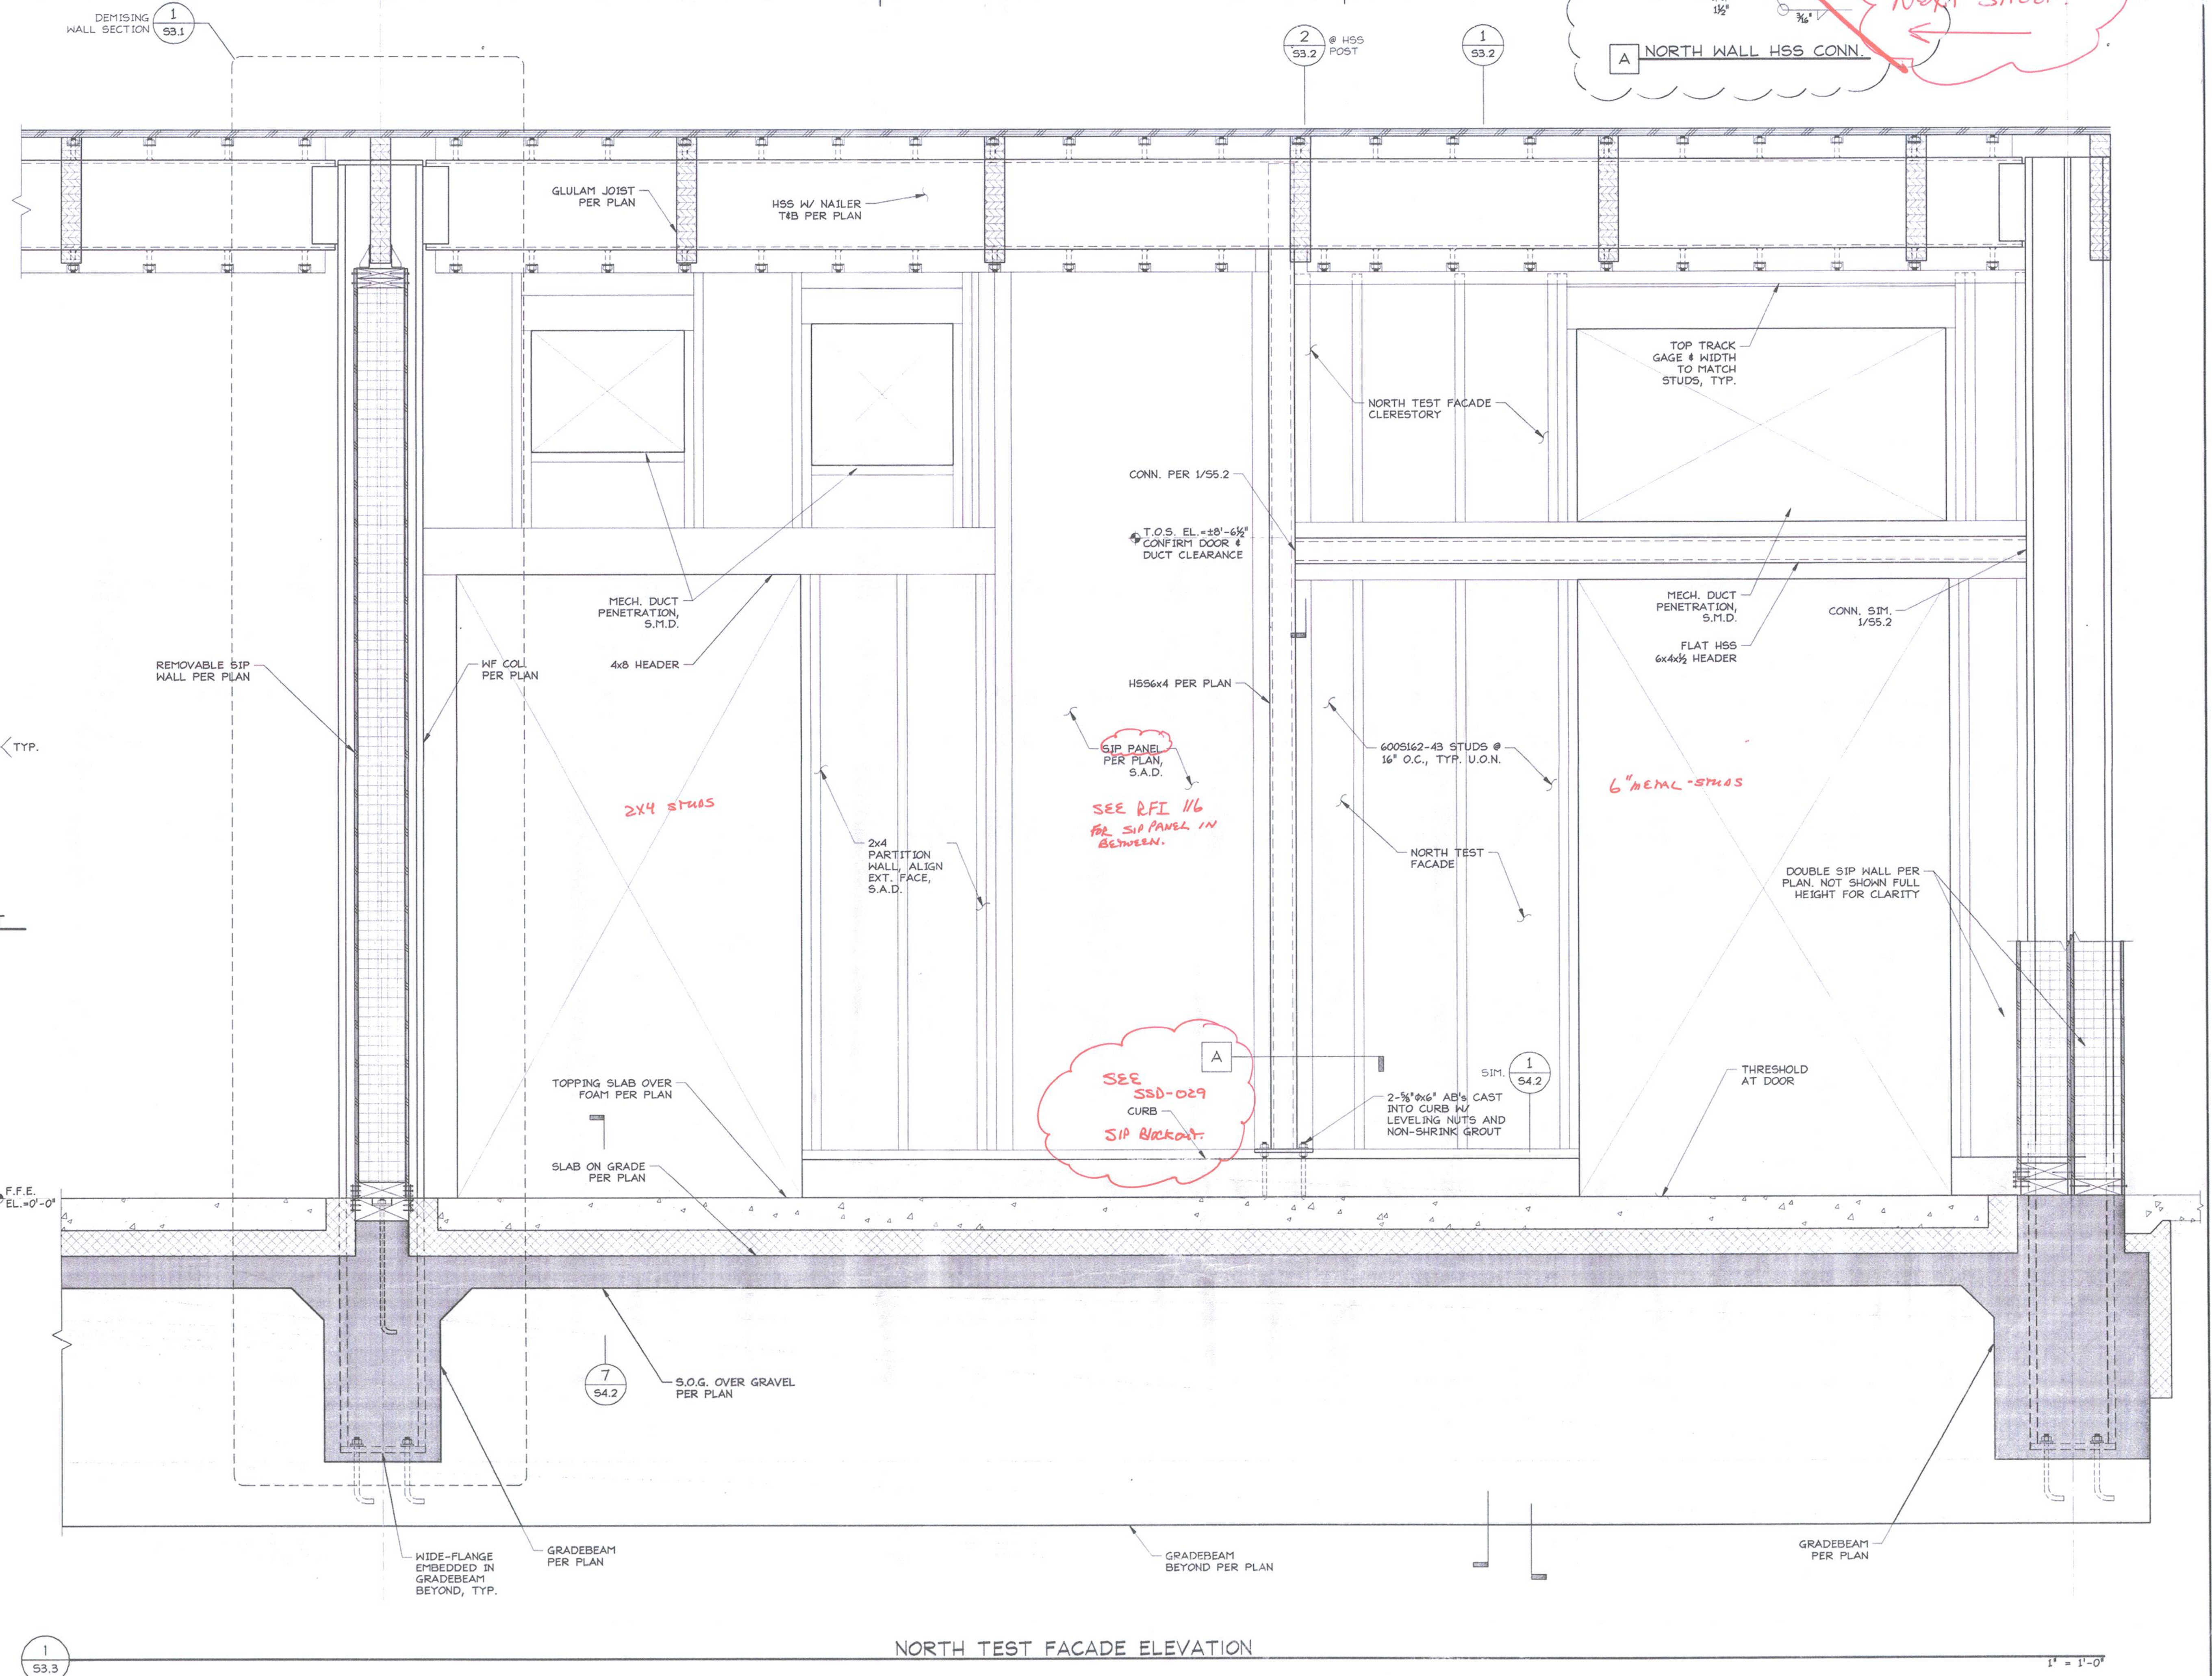
NORTH F.O. CURB STEPS AT SIP PANEL



EXT. F.O. CONC. CURB

SEE
SSD 04
NEXT SHEET

15"
 $\frac{1}{2}"$
 $\frac{3}{4}"$

A NORTH WALL HSS CONN.



<div></div> <div>Stantec</div> <div>901 Market Street San Francisco, CA 94103</div> <div>Tel: (415) 281 5 xxx Fax: (415) 882 9563</div> <div>www.stantec.com</div>		<div>TIPPING MAR</div> <div>STRUCTURAL ENGINEERING</div> <div>1906 Shattuck Ave. Berkeley, CA 94704 510 549-1906 510 549-1912 fax</div> <div>TM PROJECT NO.: 2010,062</div>	<div></div>	ASI #14	<div>6</div> CTT JRW JRW 05/11/12 ISSUE FOR CONSTRUCTION	Project name User Test Bed Facility (UTBF) Project Lawrence Berkeley National Laboratory University Of California	Drawn By NAL	Date 11/14/2011				
					<div>13</div> CTT JRW JRW 09/19/12 ASI-7		Checked By JRW	Date 11/14/2011				
					<div>14</div> CTT JRW JRW 11/30/12 ASI-9		Approved By JRW	Date 11/14/2011				
					<div>16</div> DN JRW JRW 01/04/13 ASI-11		CAD file path 062S3-3					
					<div>18</div> DN JRW JRW 01/09/13 ASI-13		Title: WALL ELEVATIONS					
Architect	Consulting Firm	Consulting A/E Firm	Professional Seal (If Revision applies only to revised work)	Issue (Progress, estimate, bid, construction, conformed, revision, as-built)	<div>19</div> DN JRW JRW 01/17/13 ASI-14	LAWRENCE BERKELEY NATIONAL LABORATORIES FACILITIES DIVISION	Scale As Noted	Sheet no: S3.3 4B90XS010				
					Revision number		Drawn by	Checked by	Approved by	Date	Remarks	Project No: 6947816 Project ID: FNO100