


Stantec

901 Market Street
San Francisco, CA 94103
Tel: (415) 281 5 xxx
Fax: (415) 882 9563
www.stantec.com

Architect

Consulting Firm

Consulting A/E Firm



Professional Seal (if revision applies only to revised work)

 RECORD DRAWINGS
4/24/2014

Issue (Progress, estimate, bid, construction, conformed, revision, as-built)

Revision number	Drawn by	Checked by	Approved by	Date	Remarks
2				01/19/2012	BID ADDENDUM # 2
6				05/11/2012	ISSUE FOR CONSTRUCTION

Project name

User Test Bed Facility
(UTBF) Project
Lawrence Berkeley
National Laboratory
University Of California

LAWRENCE BERKELEY NATIONAL LABORATORIES
FACILITIES DIVISION

Drawn by

Date

Checked by

Date

Approved by

Date

CAD file path

C:\Users\GChandru\Documents\UTBF - TestBeds-1-4_schardru.rvt

Title: EXTERIOR DETAILS

Scale: 1 1/2" = 1'-0"


Sheet no:

Project No: 6947816


A8.01

Project ID: FNO100


4B90XA027

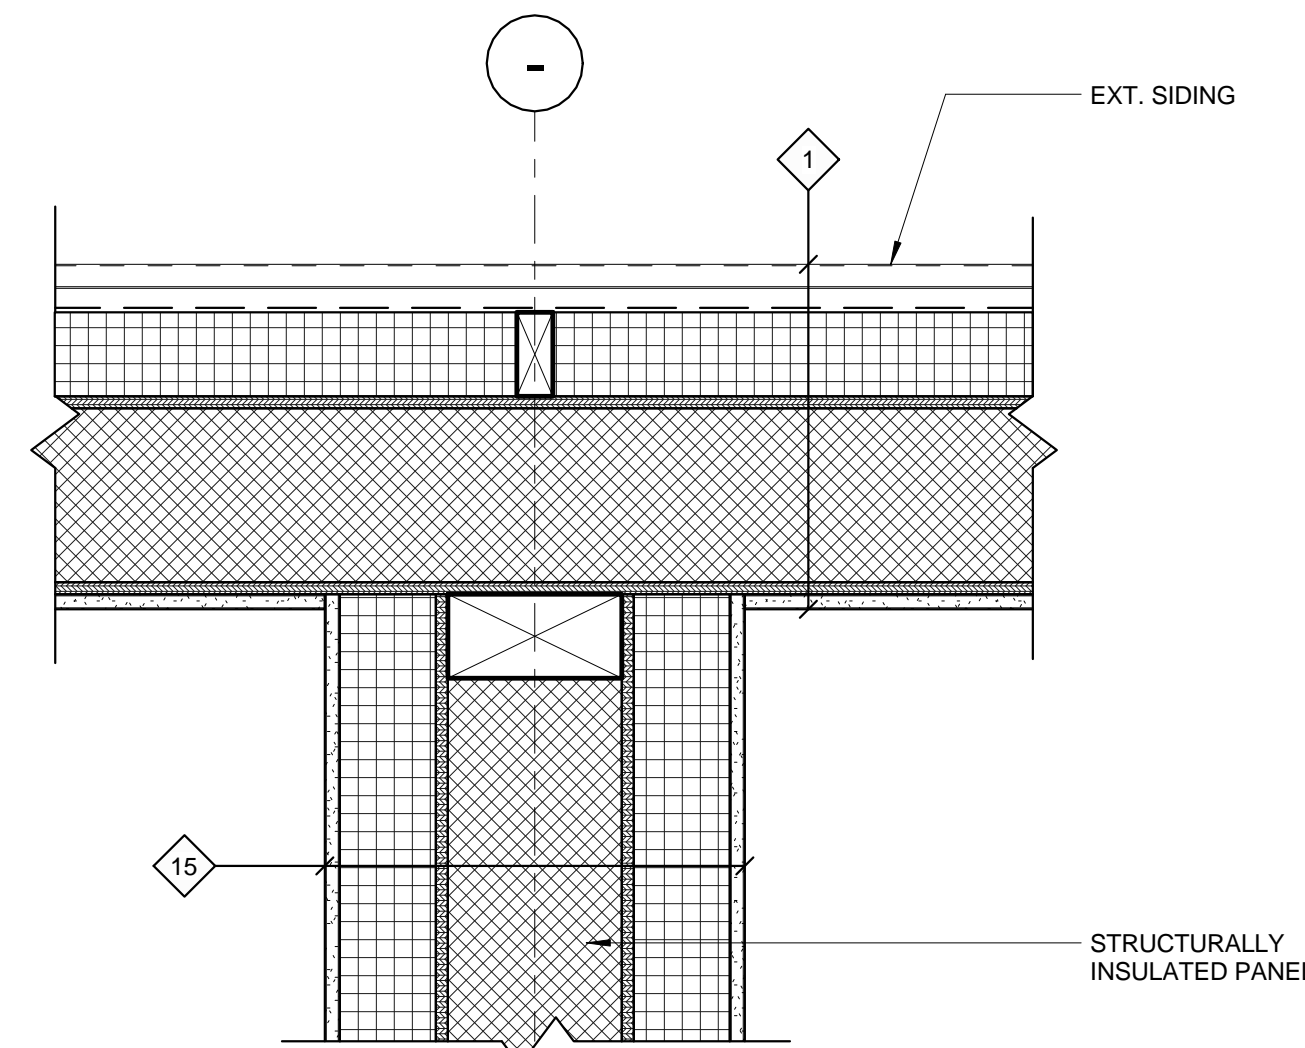


9 PLAN - NorthWall @ Mech-Mech
1 1/2" = 1'-0"

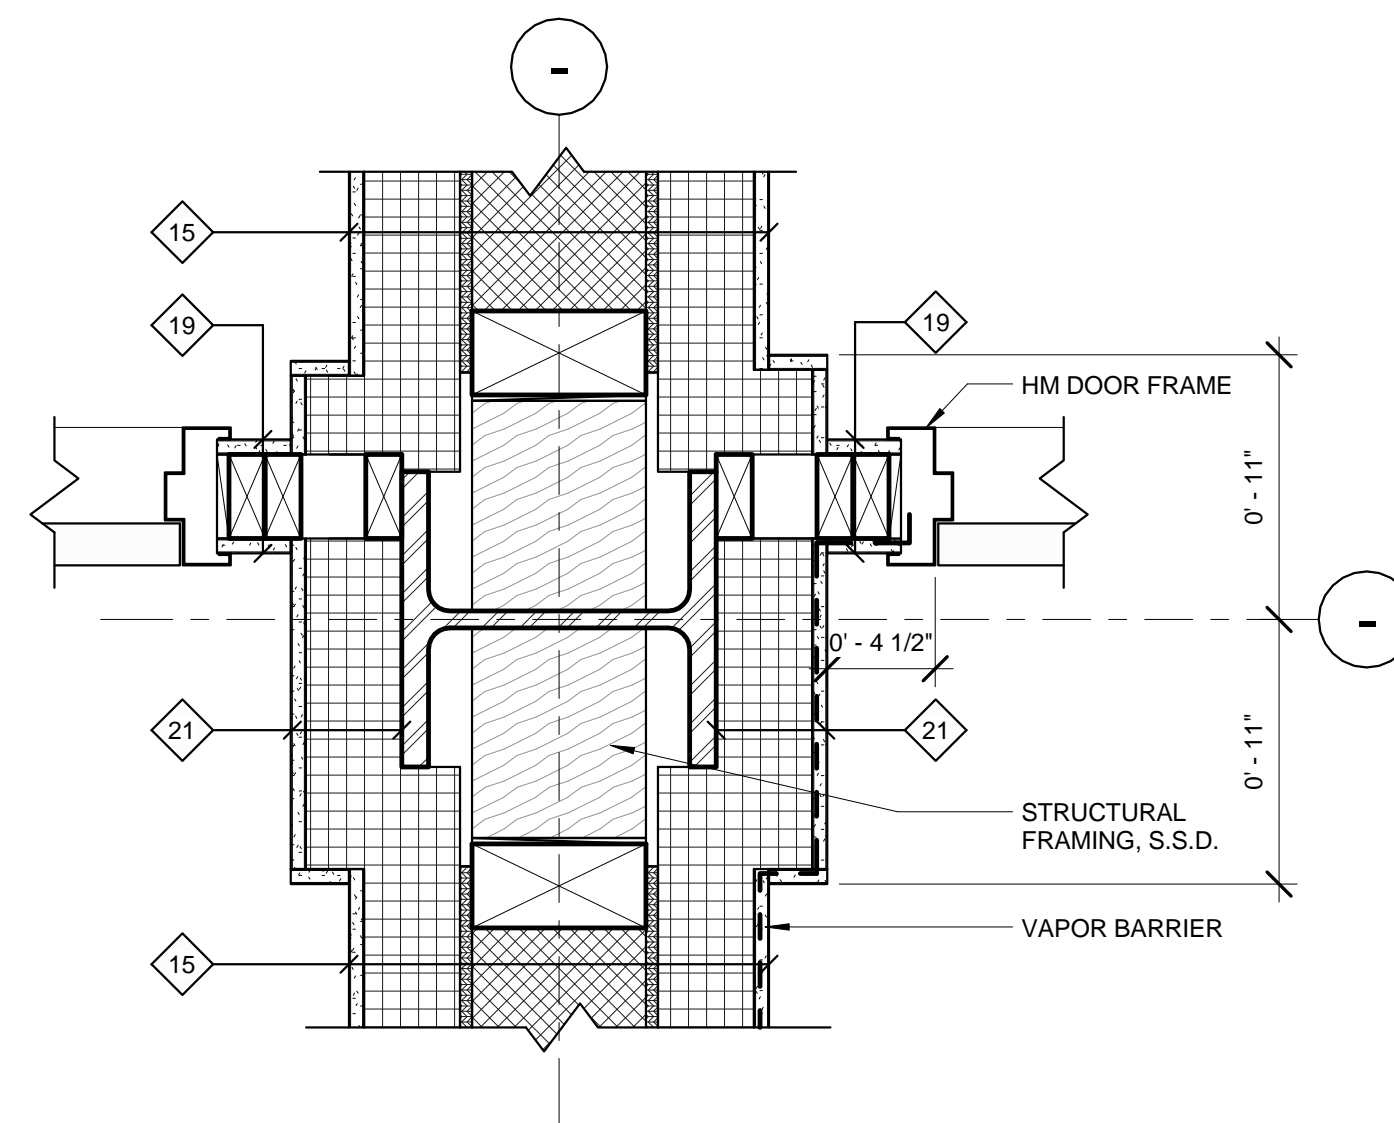


8 PLAN - WALL INTERSECTION @ MECH
1 1/2" = 1'-0"

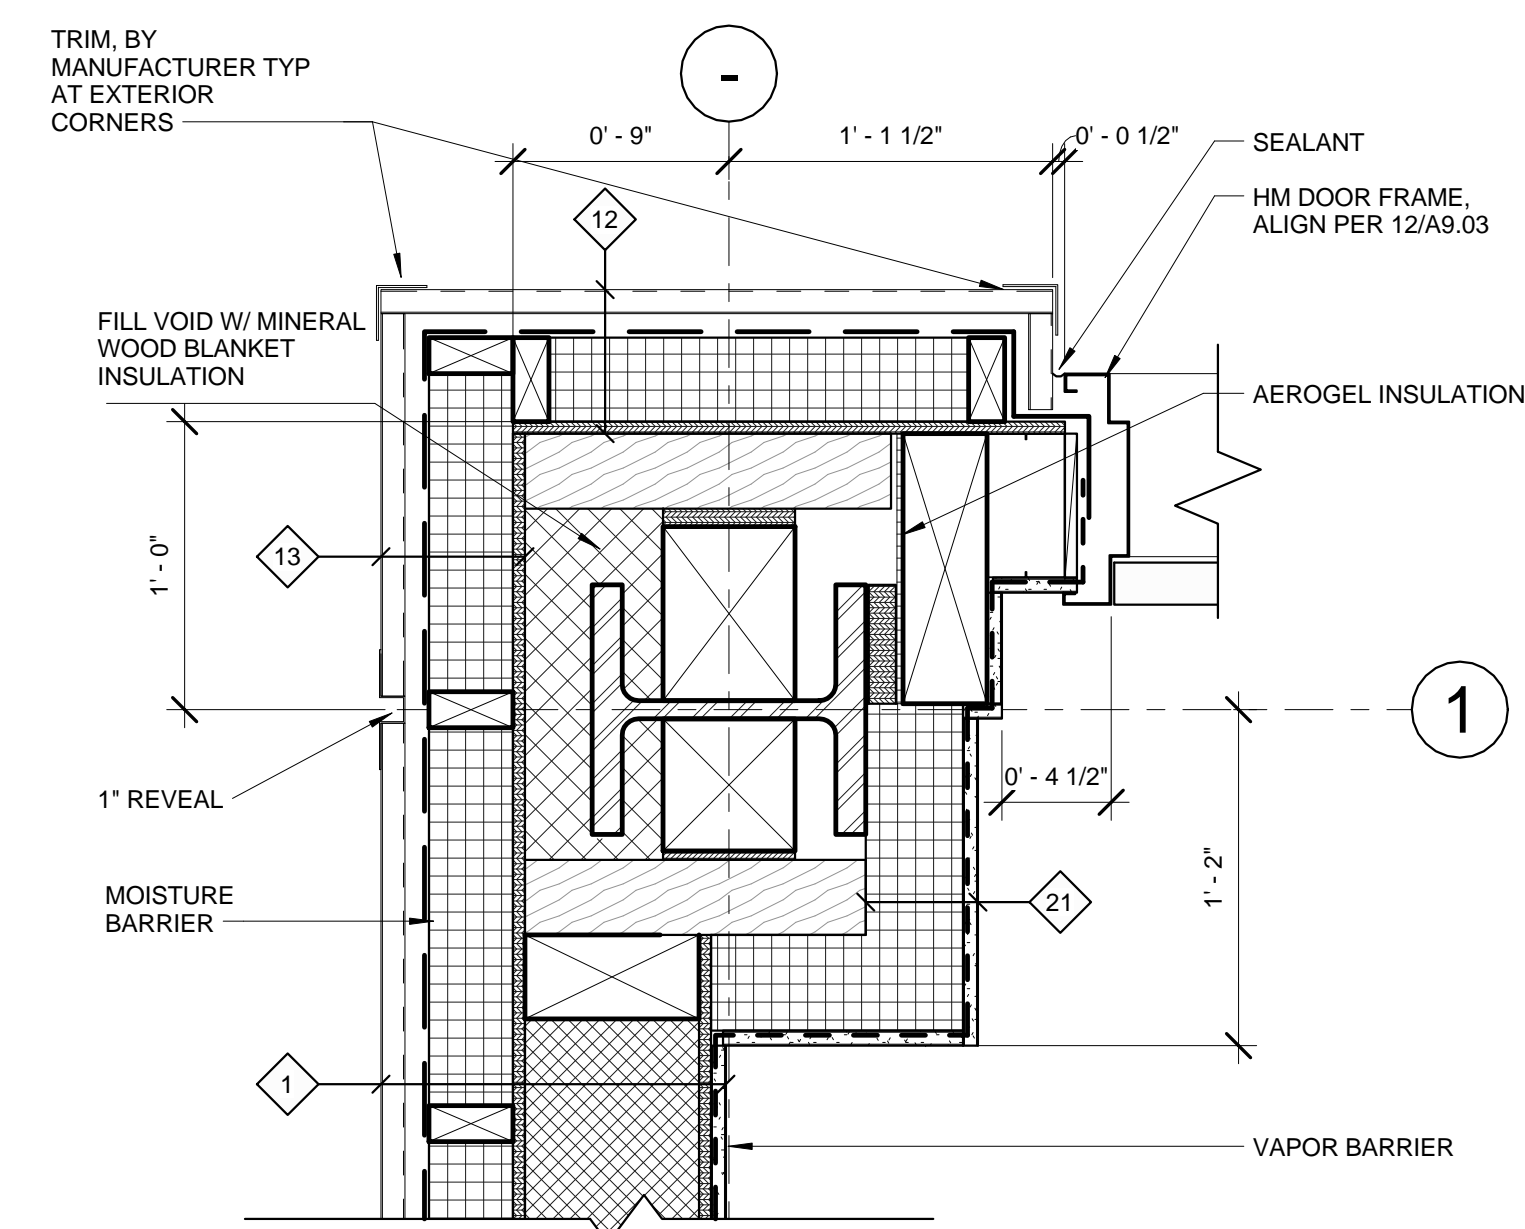


11 PLAN - Corner @ NORTH
1 1/2" = 1'-0"

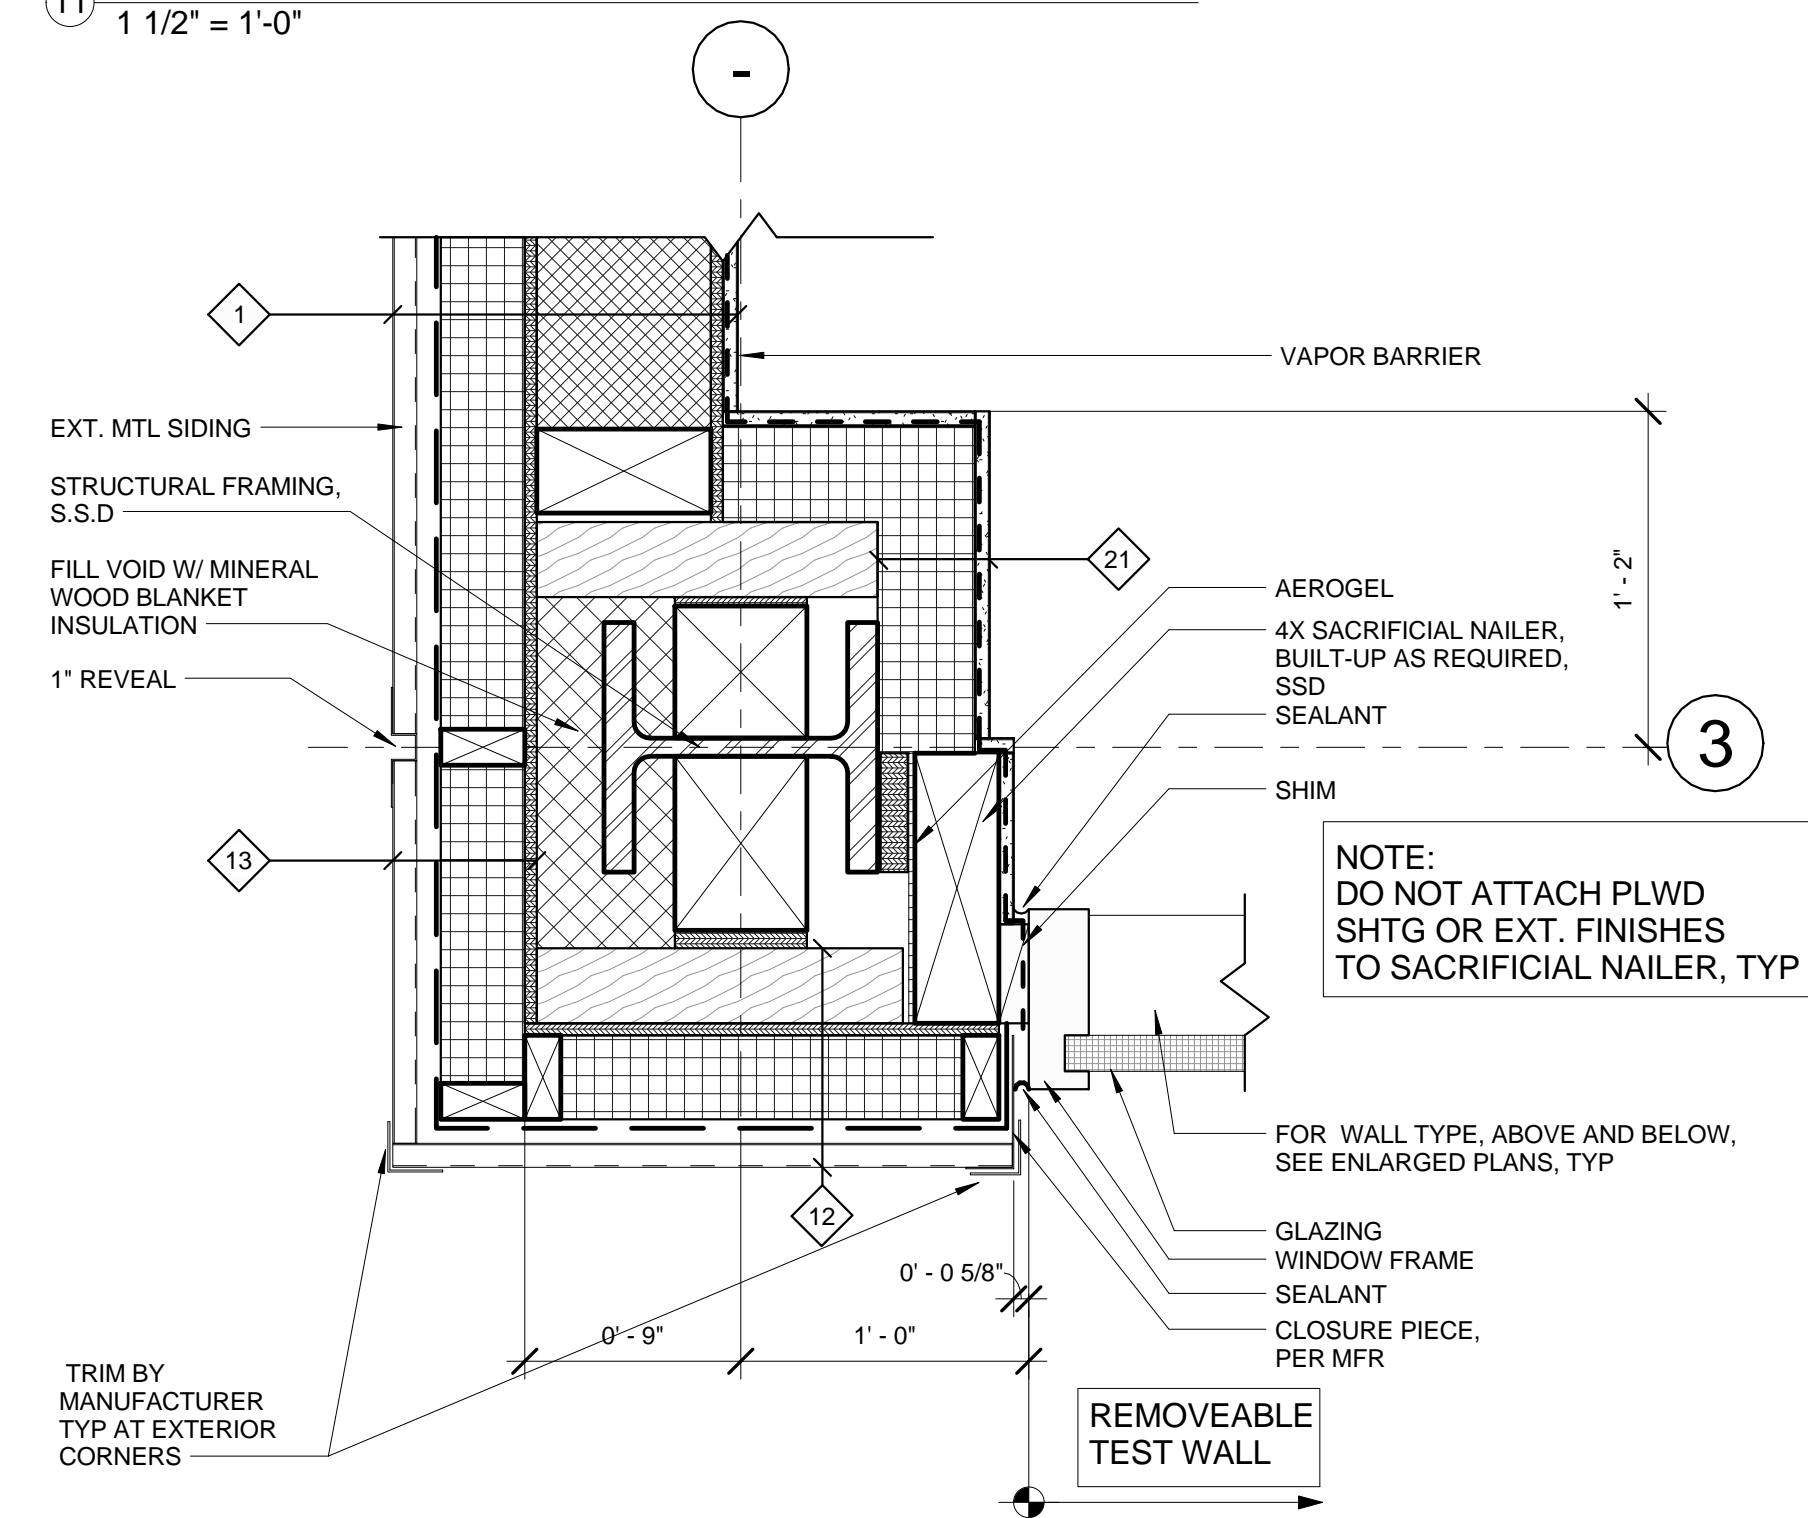


10 PLAN - Corner @ SOUTH
1 1/2" = 1'-0"

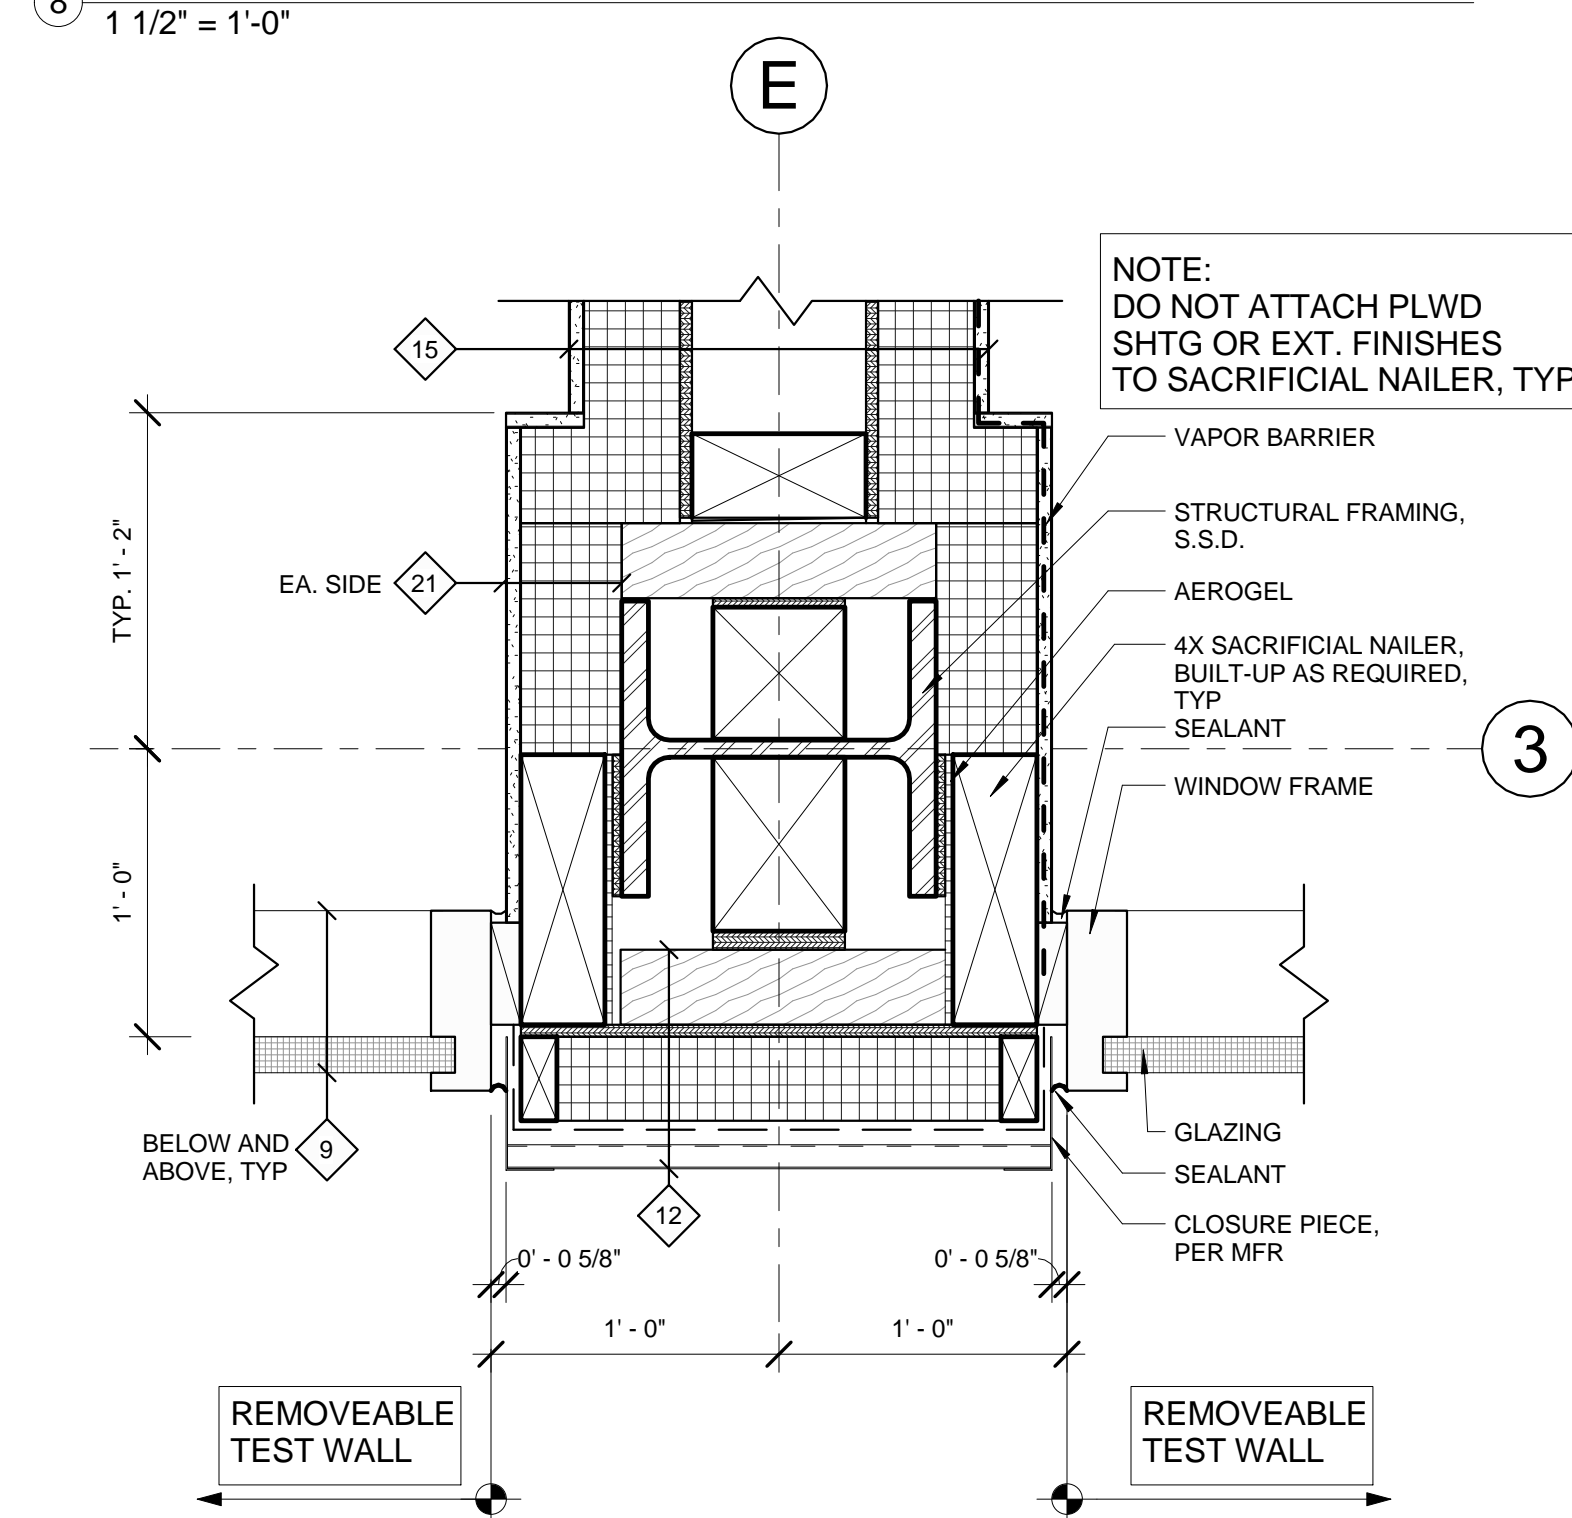


7 PLAN - WALL @ E3
1 1/2" = 1'-0"

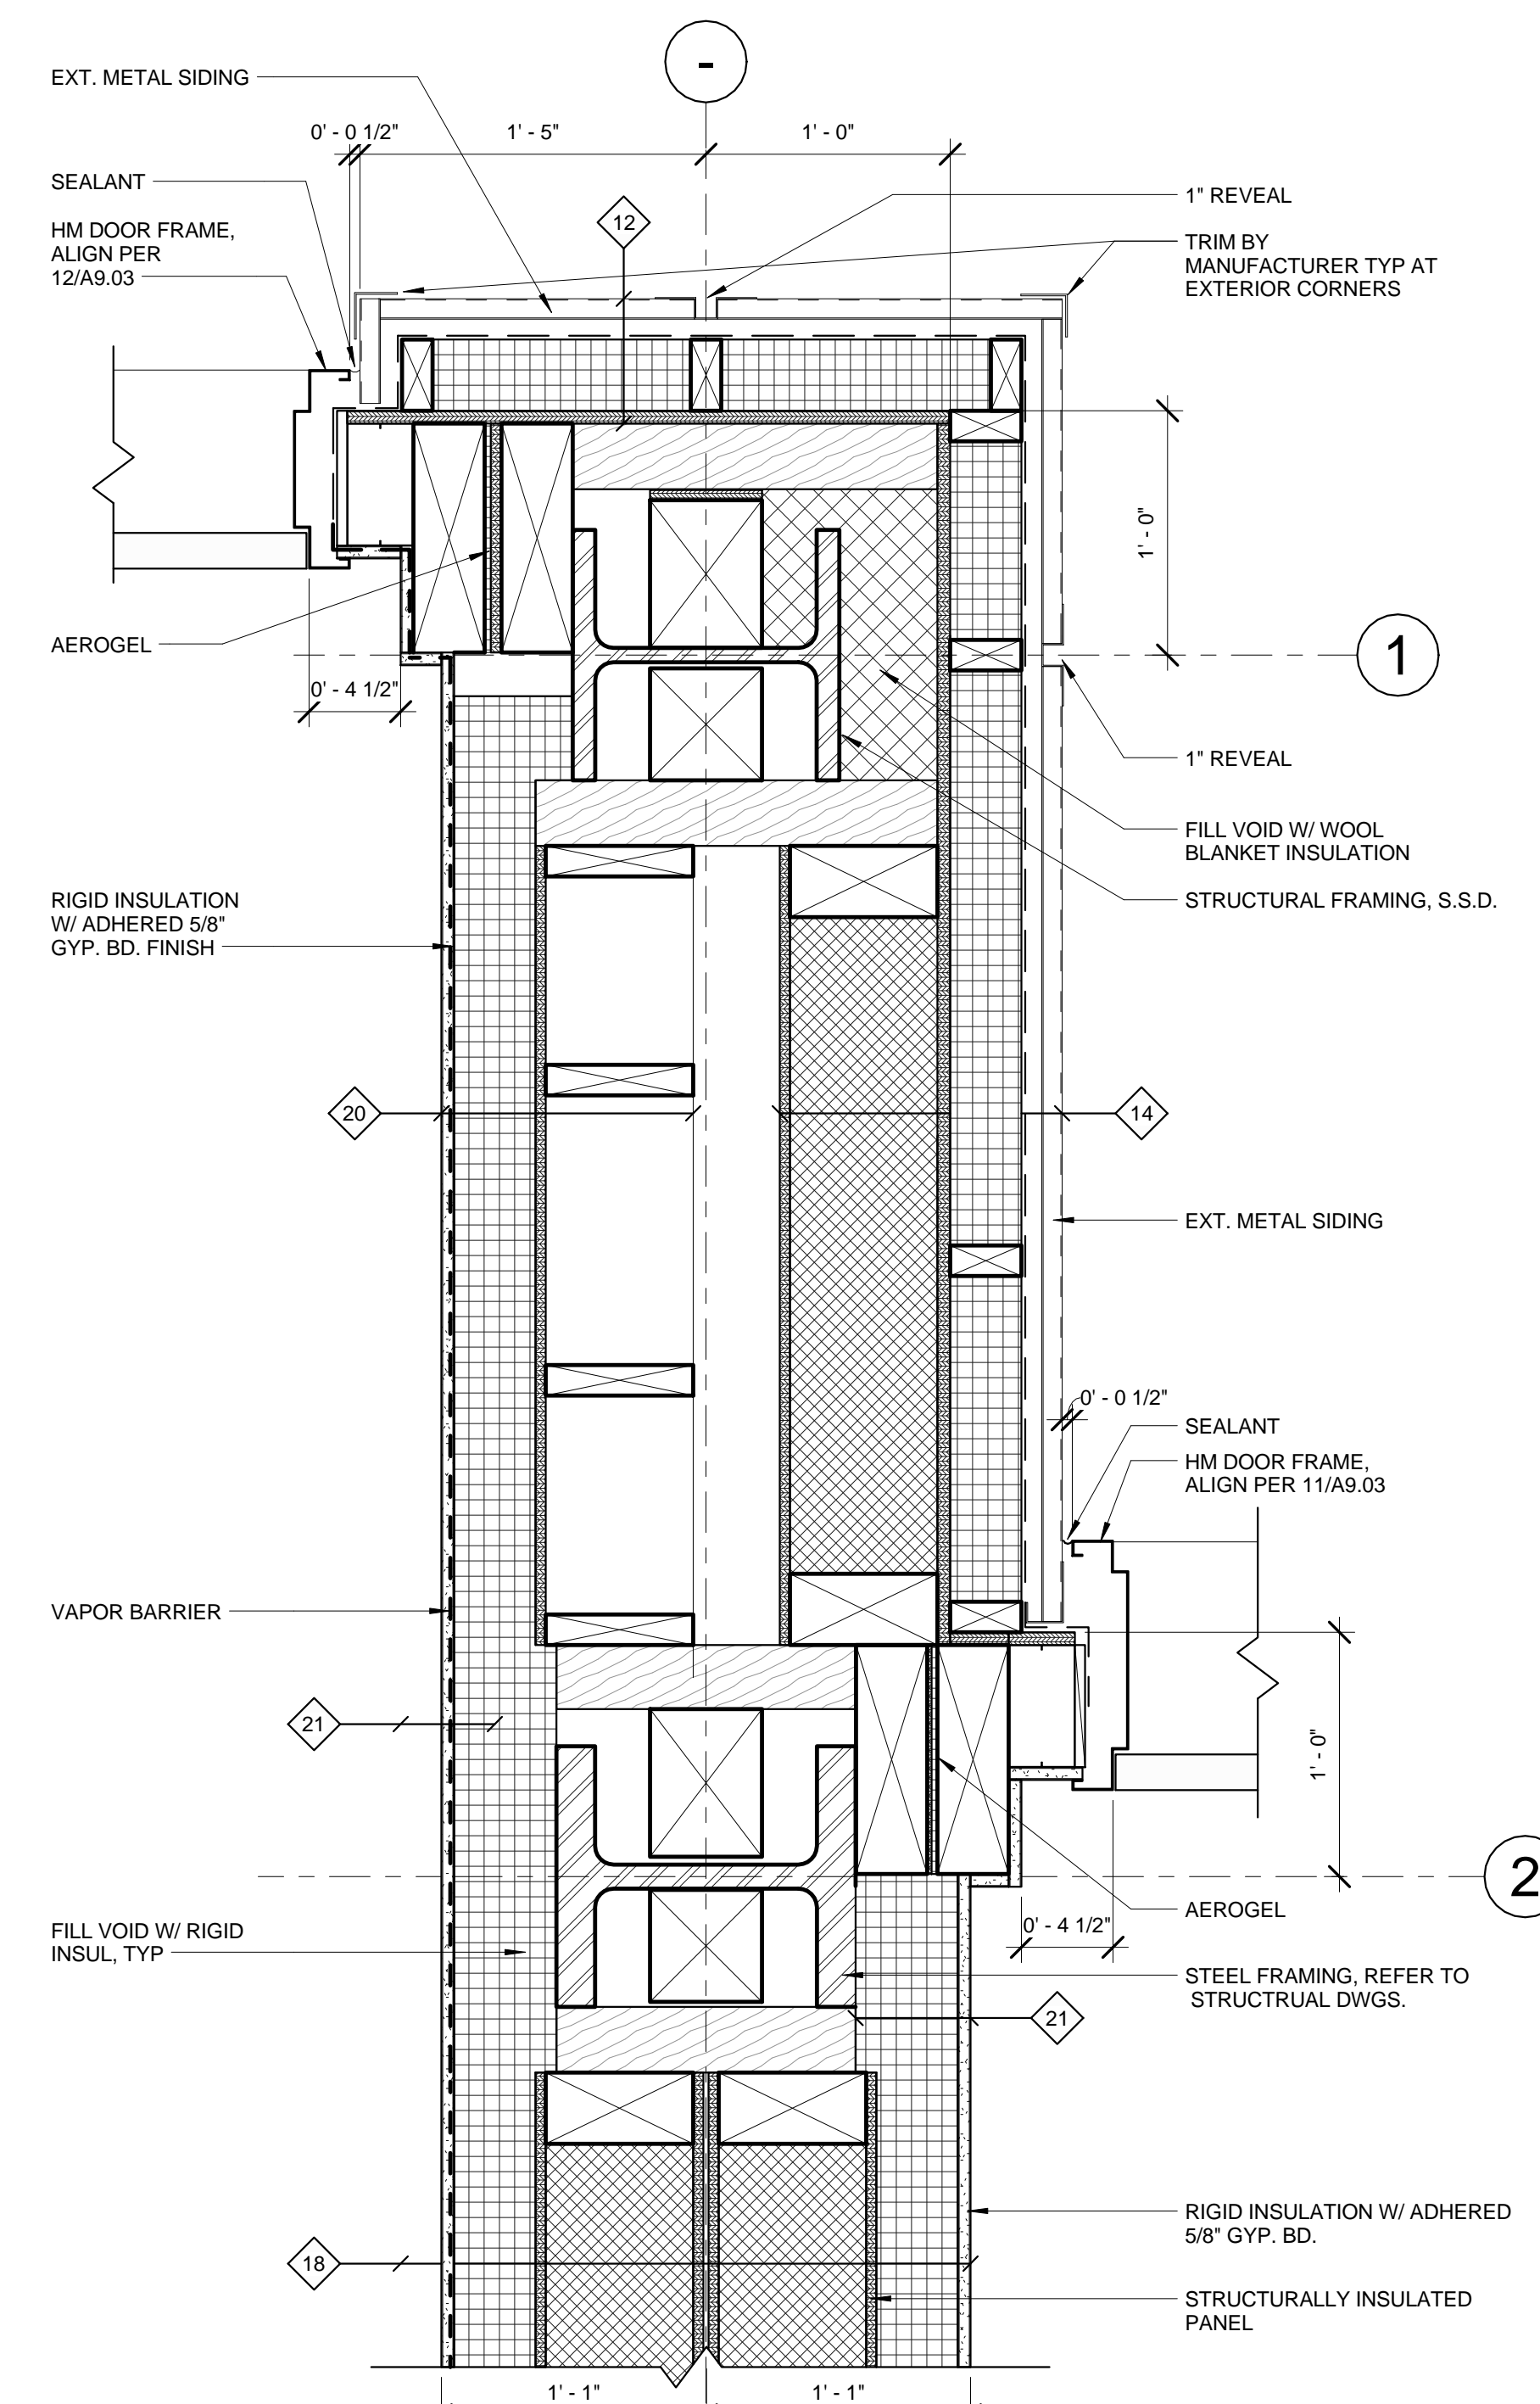


5 PLAN - NorthWall @ F
1 1/2" = 1'-0"

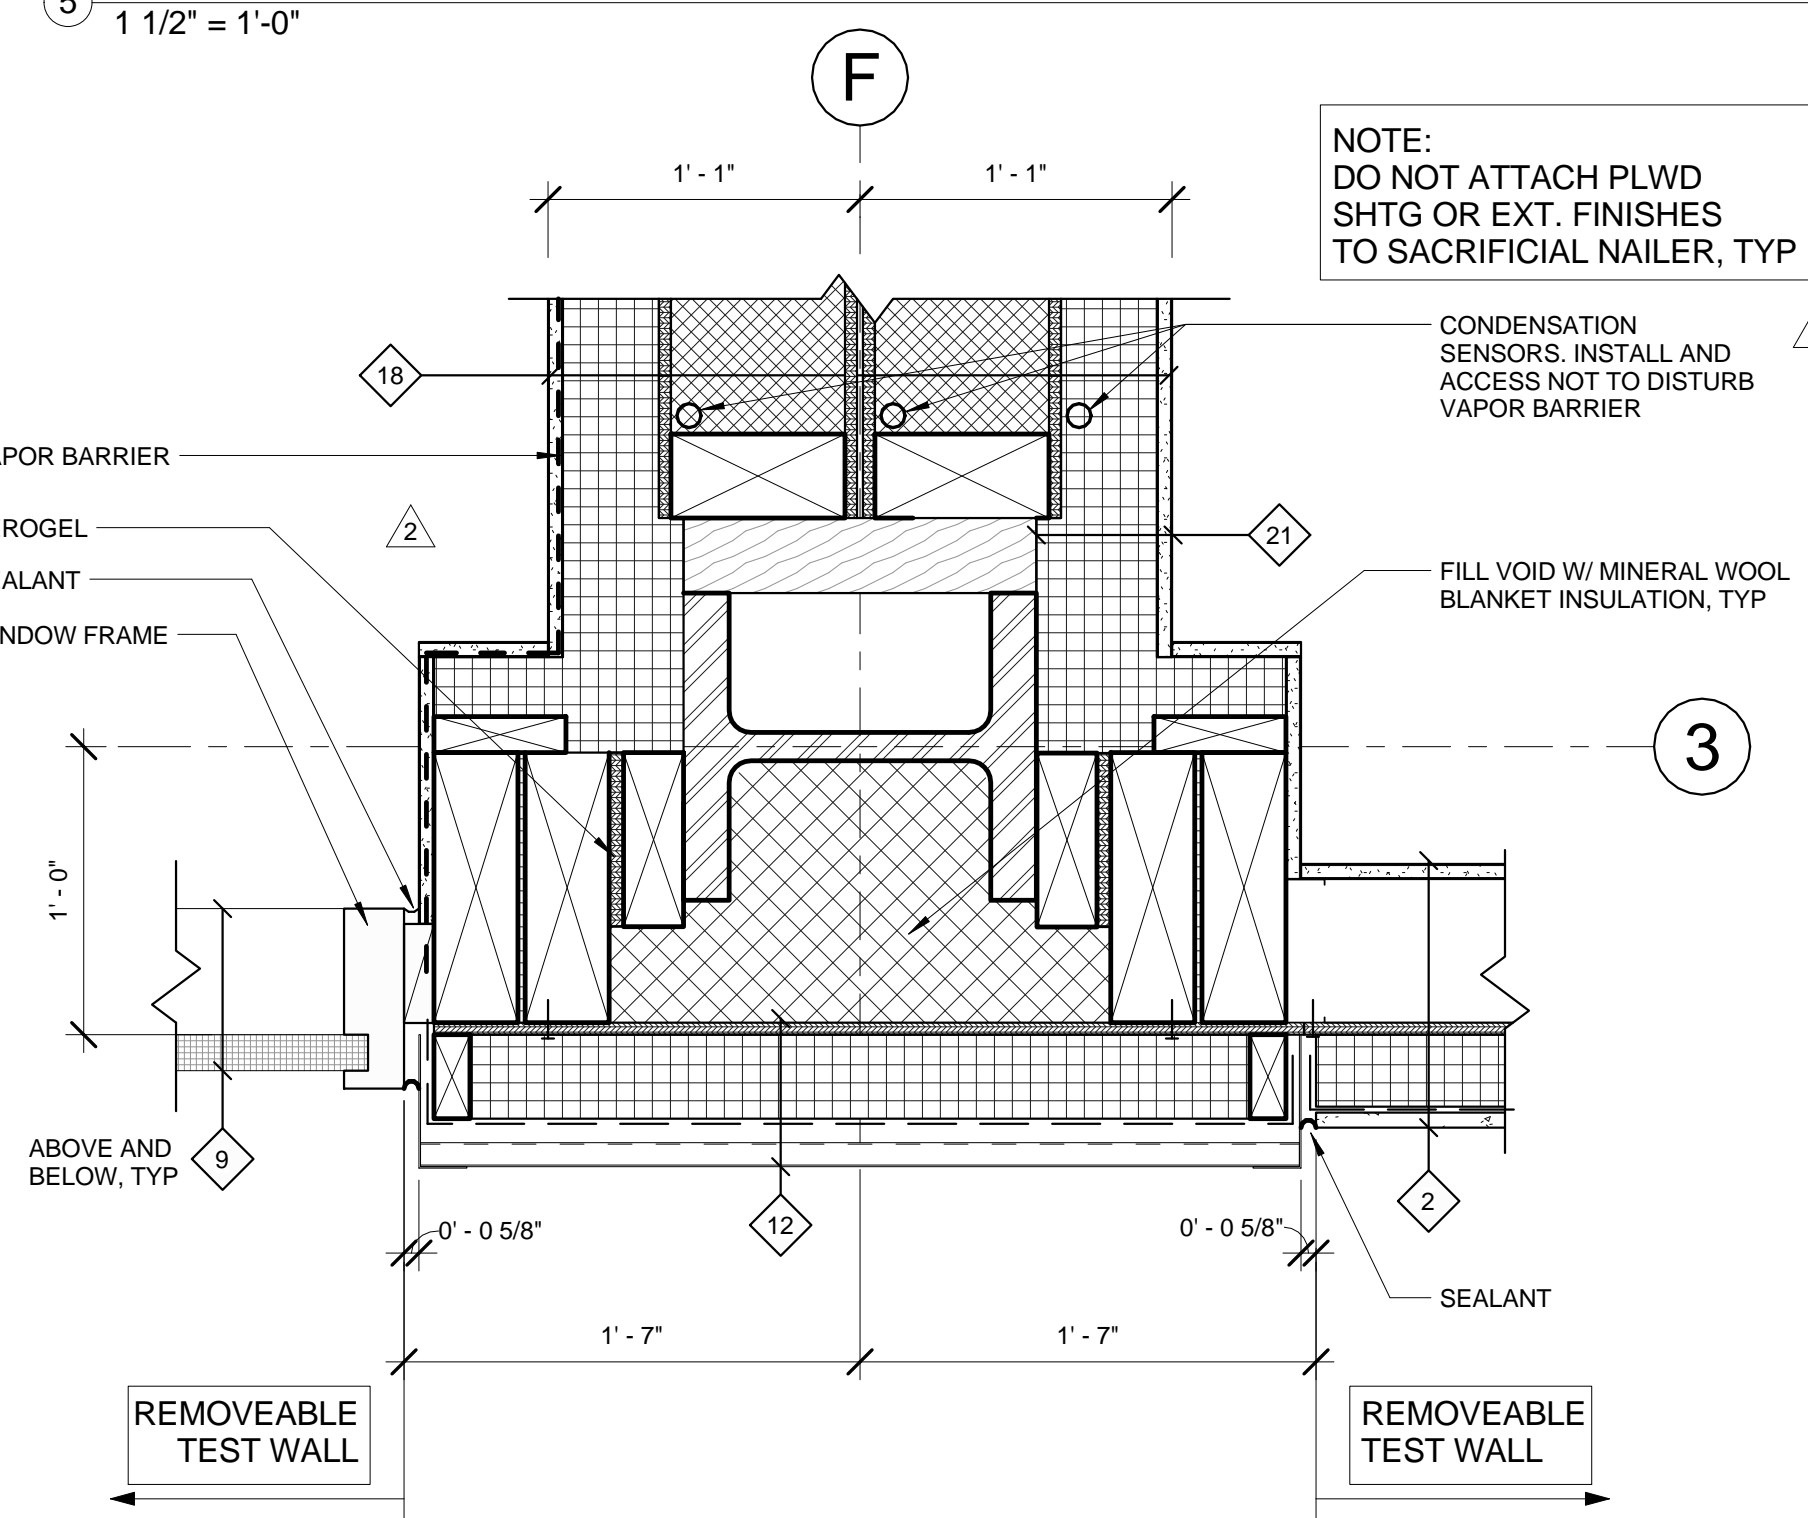

4 PLAN - SouthWall @ F
1 1/2" = 1'-0"

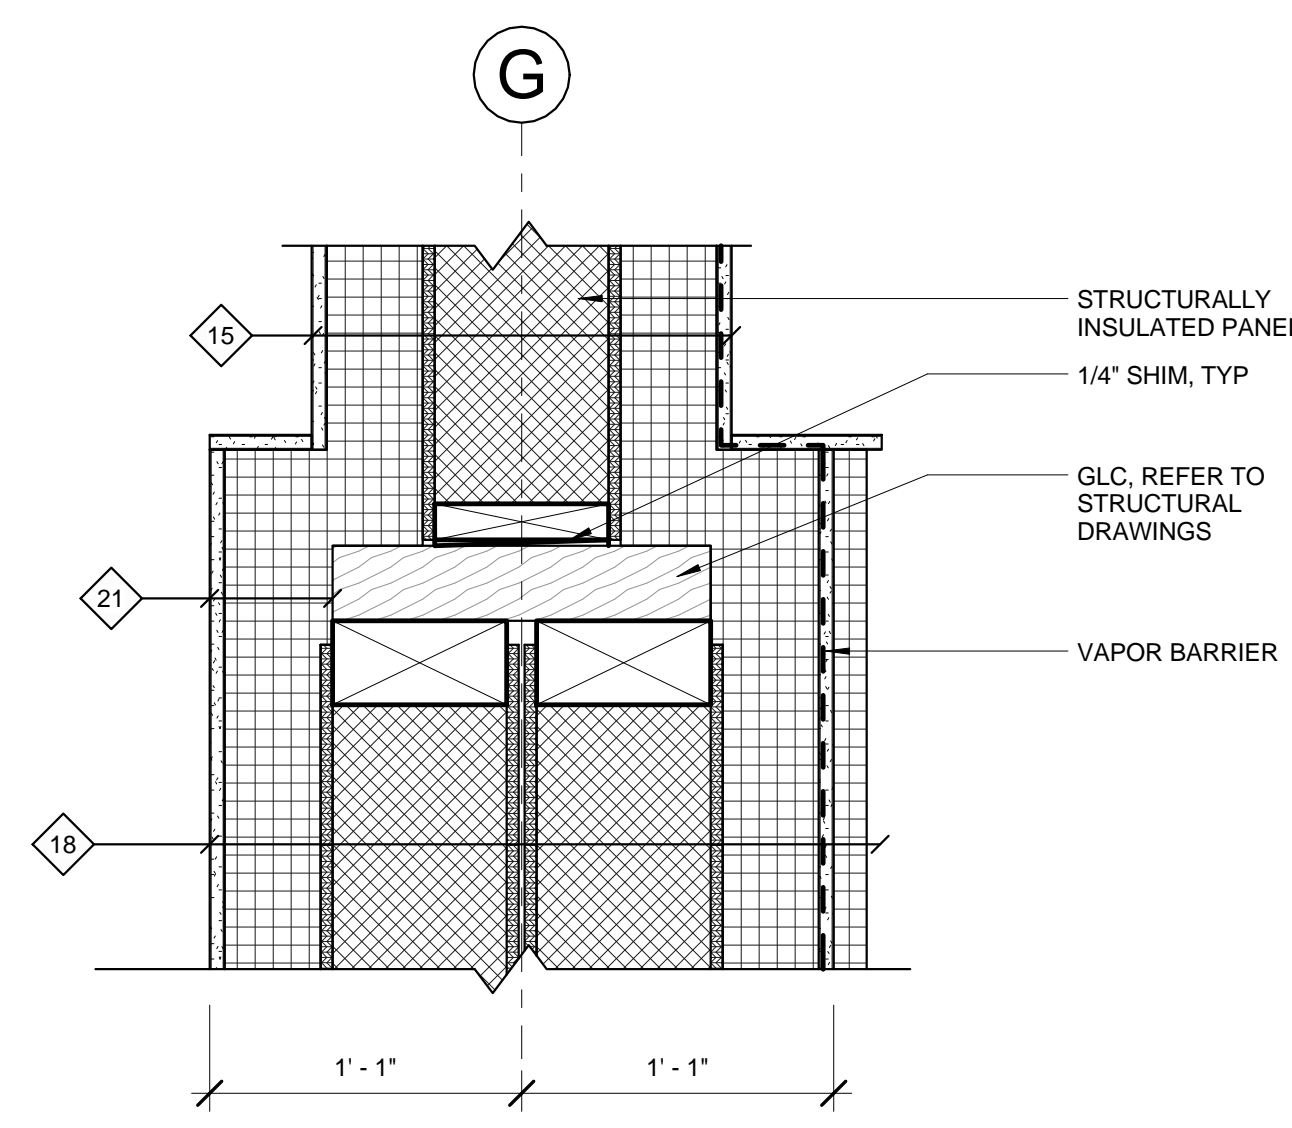

2 PLAN - WALL INTERSECTION @ G
1 1/2" = 1'-0"

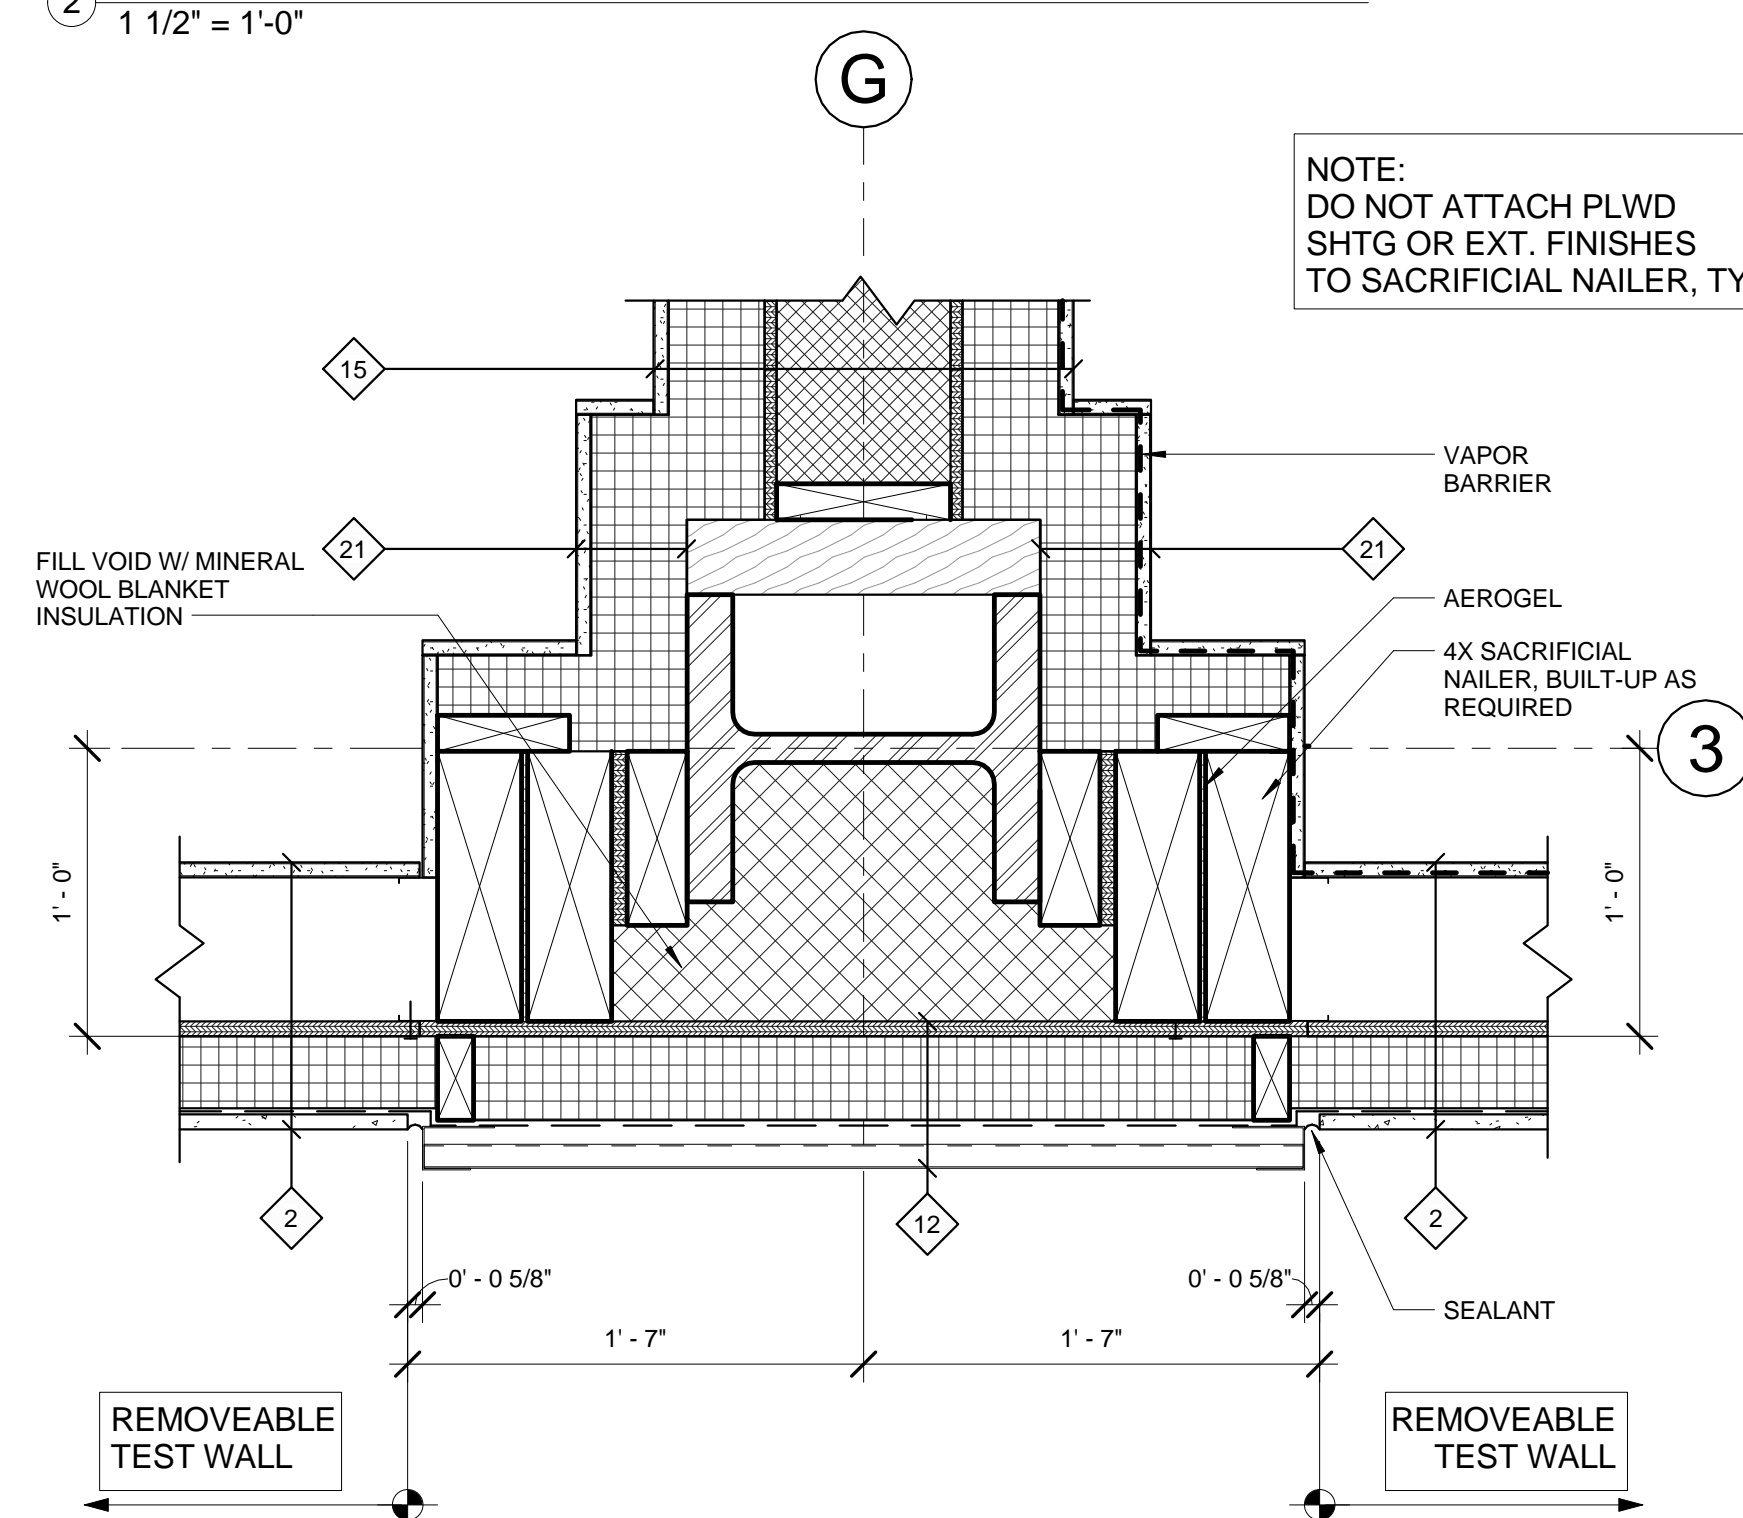

1 PLAN - SouthWall @ G
1 1/2" = 1'-0"