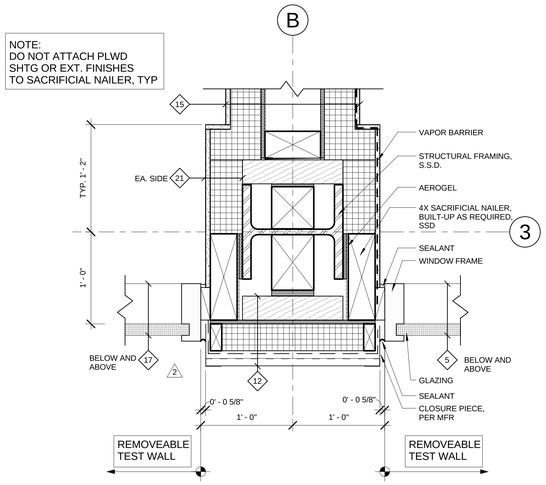

8 PLAN - SouthWall @ B3
1 1/2" = 1'-0"

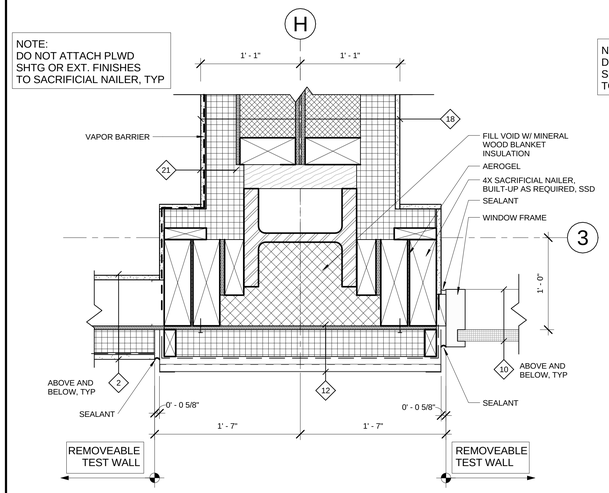

10 PLAN - SouthWall @ H
1 1/2" = 1'-0"

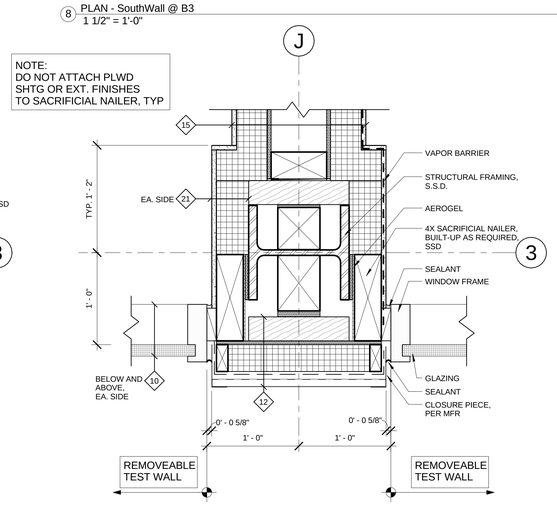

7 PLAN - SouthWall @ J3
1 1/2" = 1'-0"

2

Stantec

901 Market Street
San Francisco, CA 94103

Tel: (415) 281 5 xxx
Fax: (415) 882 9563

www.stantec.com

Architect

Consulting Firm

Consulting A/E Firm

LICENSED ARCHITECT
DONALD L. SADLER
C-15277
07/31/13
RENEWAL DATE
STATE OF CALIFORNIA

Professional Seal (if revision applies only to revised work)

RECORD DRAWINGS

4/24/2014

Issue (Progress, estimate, bid, construction, conformed, revision, as-built)

Revision number	Drawn by	Checked by	Approved by	Date	Remarks
2				01/19/2012	BID ADDENDUM # 2
6				05/11/2012	ISSUE FOR CONSTRUCTION

Project name

User Test Bed Facility
(UTBF) Project
Lawrence Berkeley
National Laboratory
University Of California

LAWRENCE BERKELEY NATIONAL LABORATORIES

FACILITIES DIVISION

Drawn by	Date
Checked by	Date
Approved by	Date
CAD file path	C:\Users\SChander\Documents\LBNL - TestBeds-1-4_schande.rvt
Title:	EXTERIOR DETAILS
Scale:	1 1/2" = 1'-0"
Project No:	6947816
Project ID:	FNO100
Sheet no:	A8.02
	4B90XA028

4/24/2014 2:54:19 PM

ORIGINAL SHEET - Arch E